SHIVALIK BIOLOGICAL PARK, JAMMU

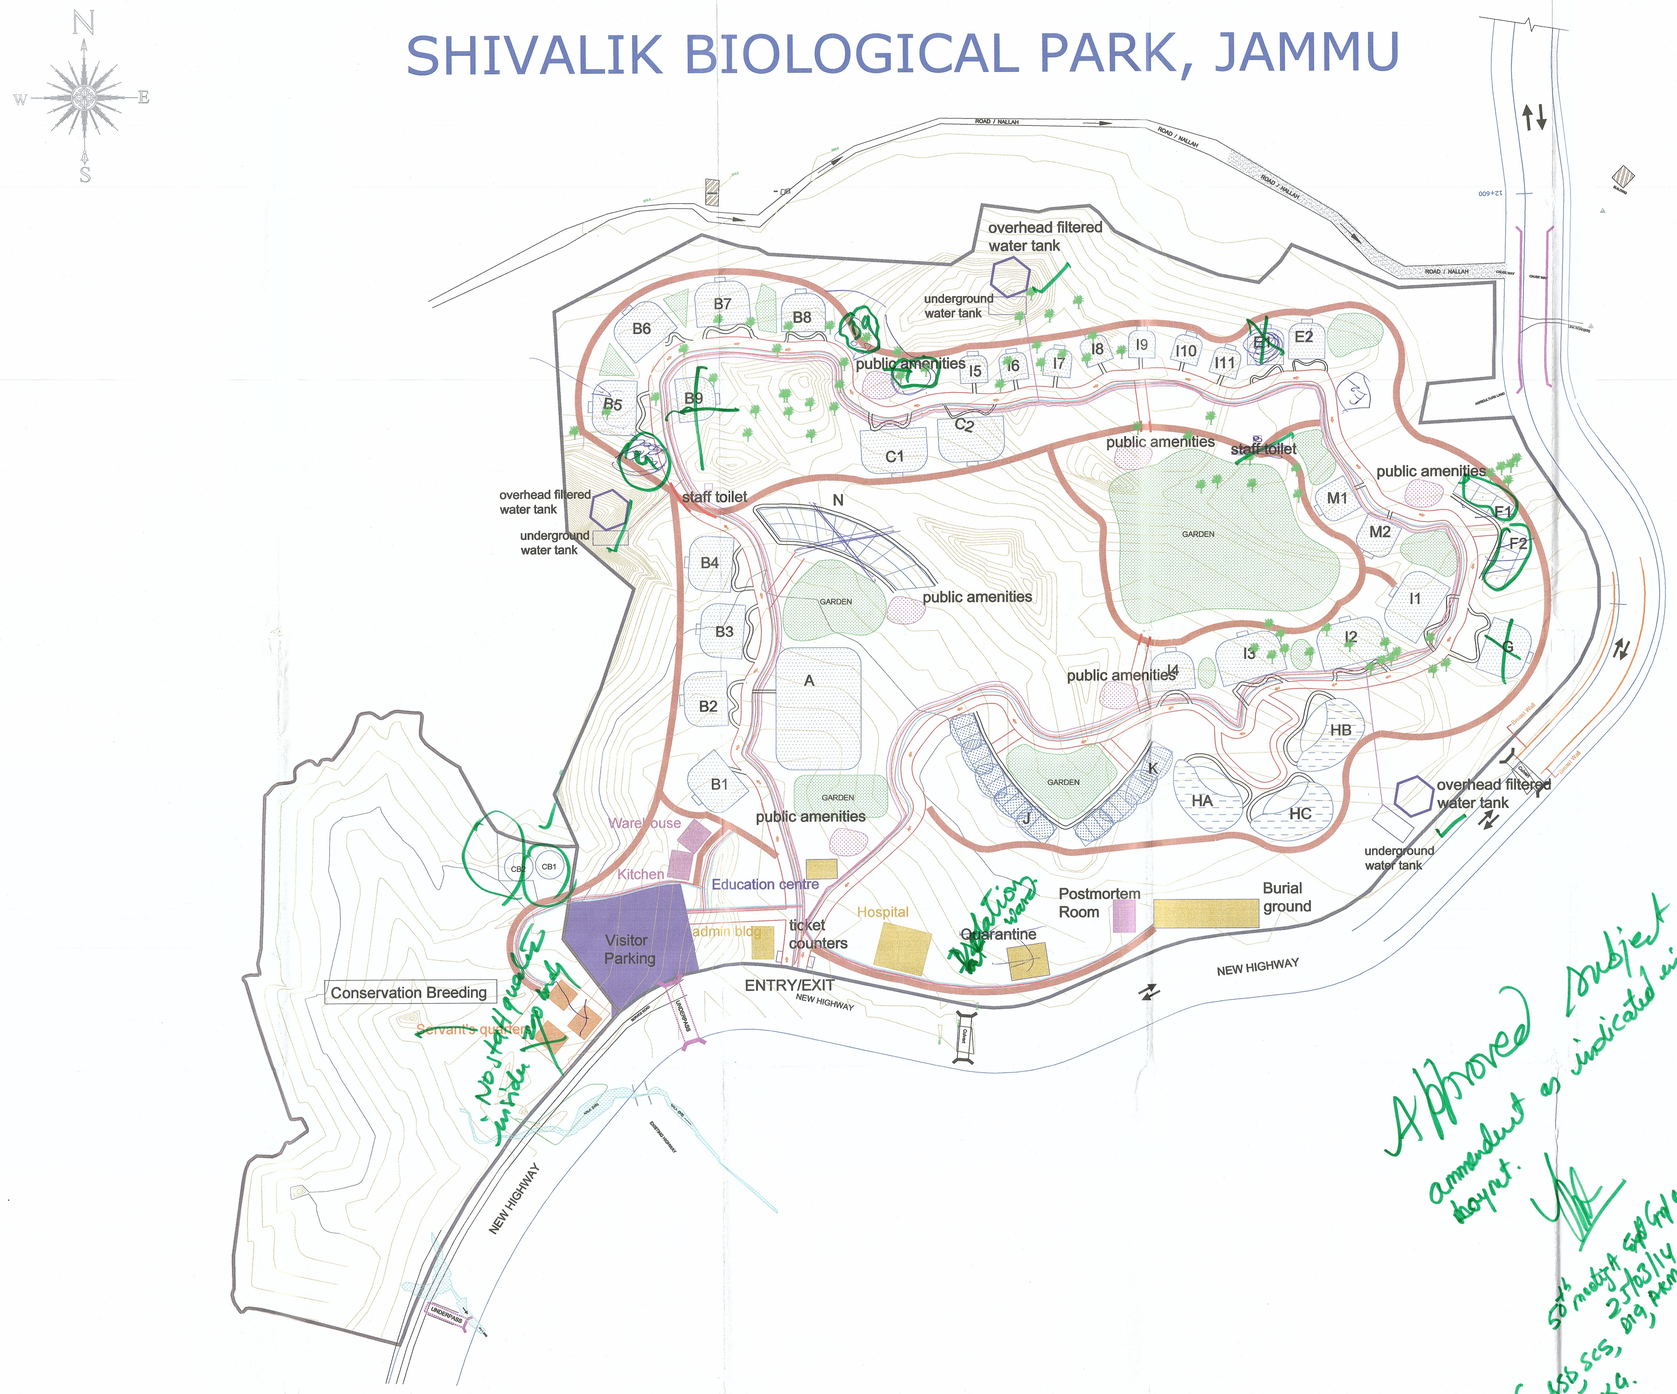

No	Legends		Name of Animal	Area (Sq.Mt)
1.		A	Butterfly garden & Insect park	8000
2.		B	Herbivores	
		B1	Sambar Deer	2000
		B2	Spotted Deer	2000
		B3	Blue Bull	2000
		B4	Black Buck	2000
		B5	Barking Deer	2000
		B6	Hog Deer	2000
		B7	Antelope Four Horned	2000
		B8	Goral	1500
		B9	Goat Wild	1500
	TOTAL			17000
3.		C	Omnivore	
		C1	Bear Himalayan Black	2500
		C2	Bear Sloth	2500
	TOTAL			5000
4.		E	Primates	
		E1	Rhesus Macaque	1000
		E2	Common Langur	1000
	TOTAL			2000
5.		F	Raptors	
		F1	Eagle tawny	350
		F2	Kite Brahminy	350
		~~F3~~	~~Shikra~~	350
		~~F4~~	~~Vulture Himalayan Gifton~~	350
		~~F5~~	~~Vulture White Backed Bengal~~	350
		~~F6~~	~~Vulture Slender billed~~	350
	TOTAL			2100
6.		G	Rodent and Boar	
			Wild Boar	2000
7.		H	Acquatic aviary	
		A	WATER FOWLS	1500
		B	STORKS AND CRANES	2000
8.		C	PELICANS ~~AND FLAMINGOES~~	2000
	TOTAL			5500
11.		I	Carnivore	
		I1	Lion	2500
		I2	Tiger	2500
		I3	White Tiger	2500
		I4	Leopard	1500
		I5	Jackal	600
		I6	Striped hyena	600
		I7	wolf	600
		I8	Fox	600
		I9	Leopard cat	500
		I10	Jungle cat	500
		I11	Fishing cat	500
	TOTAL			12900
12.		J	Aviary	3400
13.		K	Pheasant Aviary	3500
14.		L	Walk Thru Aviary	8000
15.		M	Reptiles	
		M1	Crocodile Marsh	1000
		M2	Gharial	1000
	TOTAL			2000
16		~~N~~	~~Reptile House~~	2550
17.		~~O~~	~~Nocturnal House~~	3300
18.		P	Veterinary Hospital	1800
19.		Q	Education center	500
20.		R	Zoo Kitchen	1000
21.		S	Administration	1000
22.		T	Staff Quarters	500 + 500
23.		U	Curator Bunglow	500
24.			Postmortem room	1000
25.			Visitor Parking	
27.			Conservation Breeding	
28.			Service road	
29.			Vehicular road	
30.			Electricity line	
31.			Drainage line	
32			Filter water line	
33.			Unfilter water line	
34.			Sewarage line	


N	REPTILE HOUSE	AREA
1	Rock Python	150
2	Cobra	150
3	King Cobra	150
4	Rat Snake	150
5	MonitorWater Lizard	150
6	Snake Green Whip	150
7	Red Sand Boa	150
8	Russell Viper	150
9	Krait Common Indian	150
10	Monitor Lizard	150
11	Soft Shelled tortoise	150
12	Star Torroise	150
13	Terrapin Red Eared	150
14	Terrapin River	150
15	Turtle Pond	150
	TOTAL	2250

K	PHEASANTAVIARY	AREA
1	Indian Peacock	500
2	Peafowl Green/Burmese	250
3	Cheer Pheasant	250
4	Kalij Pheasant	250
5	Lady Ahmerest	250
6	Pheasant Silver	250
7	Golden Pheasant	250
8	Pheasant Ring Necked	250
9	~~Pheasant Grey Peacock~~	250
10	~~Pheasant Copper~~	250
	TOTAL	2750

J	AVIARY	AREA(sq.m)
1	Hornbill Indian Pied	400
2	Hornbill common Grey	400
3	Hill Myna	200
4	Common Myna	200
5	Parakeet Blossom Headed	200
6	Rose Ring Parakeet	200
7	Parakeet Alexdrian	200
8	Budgerigars	200
9	Cockatiel	200
10	Macaw Blue	200
11	Love Peach Faced Bird	200
12	Cockatoo Sulphur Crested	200
13	African Grey Parrot	200
14	Lorikeet Ornate	200
	TOTAL	3200

H	AQUATIC AVIARY	AREA
A	WATER FOWLS	1500
1	Duck Shoveller	
2	Mallard	
3	Egret Large	
4	Grey Legged Goose	
5	White Ibis	
6	Seagull	
B	STORKS & CRANES	2000
1	Painted Stork	
2	Adjutant Stork	
3	White Stork	
4	Sarus Crane	
5	Demoiselle Crane	
C	STORKS & CRANES	2000
1	Rossy Pelicans	
2	Lesser Flamingoes	
	TOTAL	5500

Zoo Site Area :- 169 Acres

Project :-

SHIVALIK BIOLOGICAL PARK
Department of Wildlife Protection
Government of Jammu & Kashmir
Contact - Telefax: 0191-2520247

Sheet Title :- LAYOUT PLAN

Scale = 1: 1000

Consultants :-

MYVETS INTEGRATED SOLUTIONS PVT. LTD.
Shop No. 29, Aklavya CHS., Plot 69D,
Sector 21, Kharghar, Navi Mumbai : 410210
Tel. No. : 022 65345972 / Fax No. 022-27747775
Mob: +91 9833522077
Email: yuvraj.kaginkar@myvetsol.com / website: www.myvetsol.com